



2021 Community Governance Reviews

Report to Full Council – 15 December 2021

FINAL RECOMMENDATIONS


APPENDIX 4

Map Key

Blue Lines – existing parish Boundaries

Red lines – proposed parish boundaries

West Raynham – Helhoughton (1)

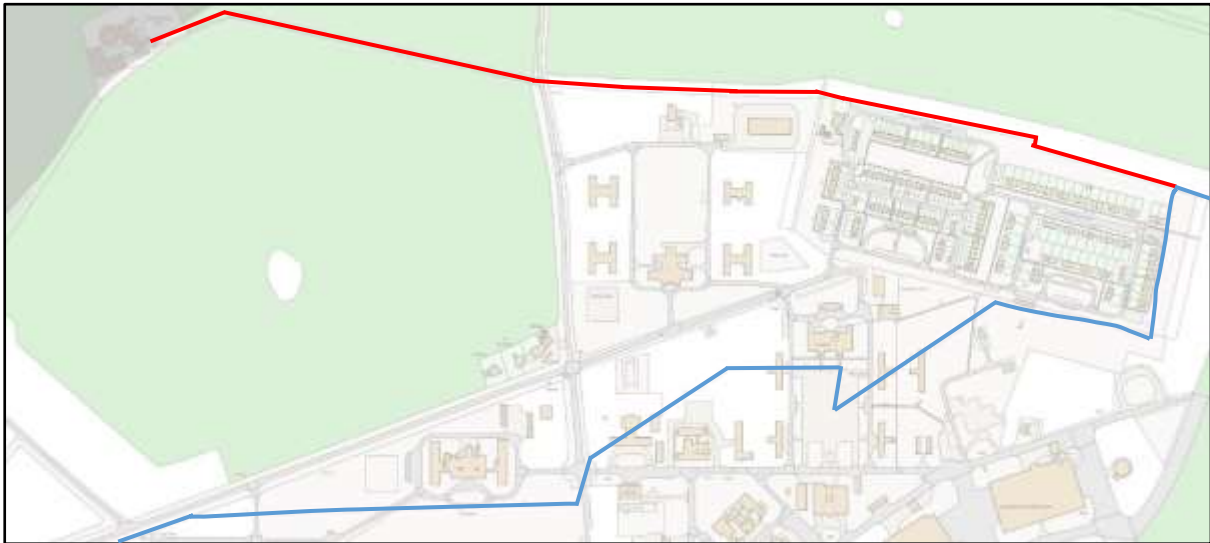

Properties Affected:

9 -76 Barsham Close, West Raynham
77 – 94 & 121 – 130 Blickling Street, West Raynham
1 – 8 Felbrigg Walk, West Raynham
27 – 38 & 115 - 120 Holkham Green, West Raynham
39 – 58 Oxburgh Square, West Raynham
95 – 102 Raynham Way, West Raynham
103 – 114 Sandringham Crescent, West Raynham

Massingham Road, West Raynham:
The Bungalow; Dursley; The Old Stores; West Raynham Auto Clinic,


NB: A full breakdown of each affected property and the Council Tax implications of moving this boundary is attached

Proposal:

This Review seeks to bring all properties who identify with the former RAF West Raynham site together within the same parish. Currently the boundary line splits the properties on the former base so it is proposed that the boundary line is move to the north so it runs along the track from the District boundary at the former Sewage works and continues along the hedgerow behind the former base and the properties on Barsham Close and Blickling Street

There will be a decrease in the Parish precept for the individual properties concerned and in terms of governance electors will have a change of polling station from Helhoughton Village Hall to Raynham Village Hall but in terms of warding arrangements, they will remain the same.

West Raynham – Helhoughton (2)

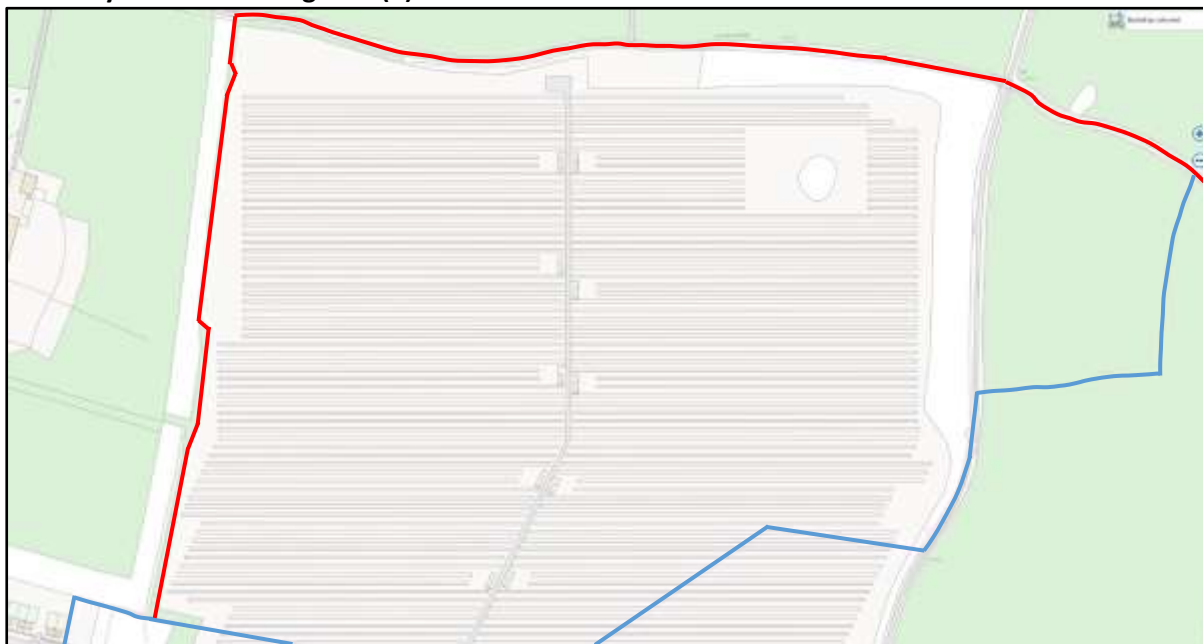

Area Affected: Raynham Solar Farm

Proposal:

Currently the boundary cuts across the site of the Solar Farm. This review seeks to tidy this boundary so the entire Solar Farm site sits within Raynham Parish by running the boundary northwards along the western side of the farm until it meets Paxfield Road. From here the Boundary would run eastwards along Paxfield road across the road until it joins with the existing Helhoughton Boundary.